


EXHIBIT #3

#AS CONSTRUCTED
UTILITIES (UNDERGROUND)

2141.
*SET

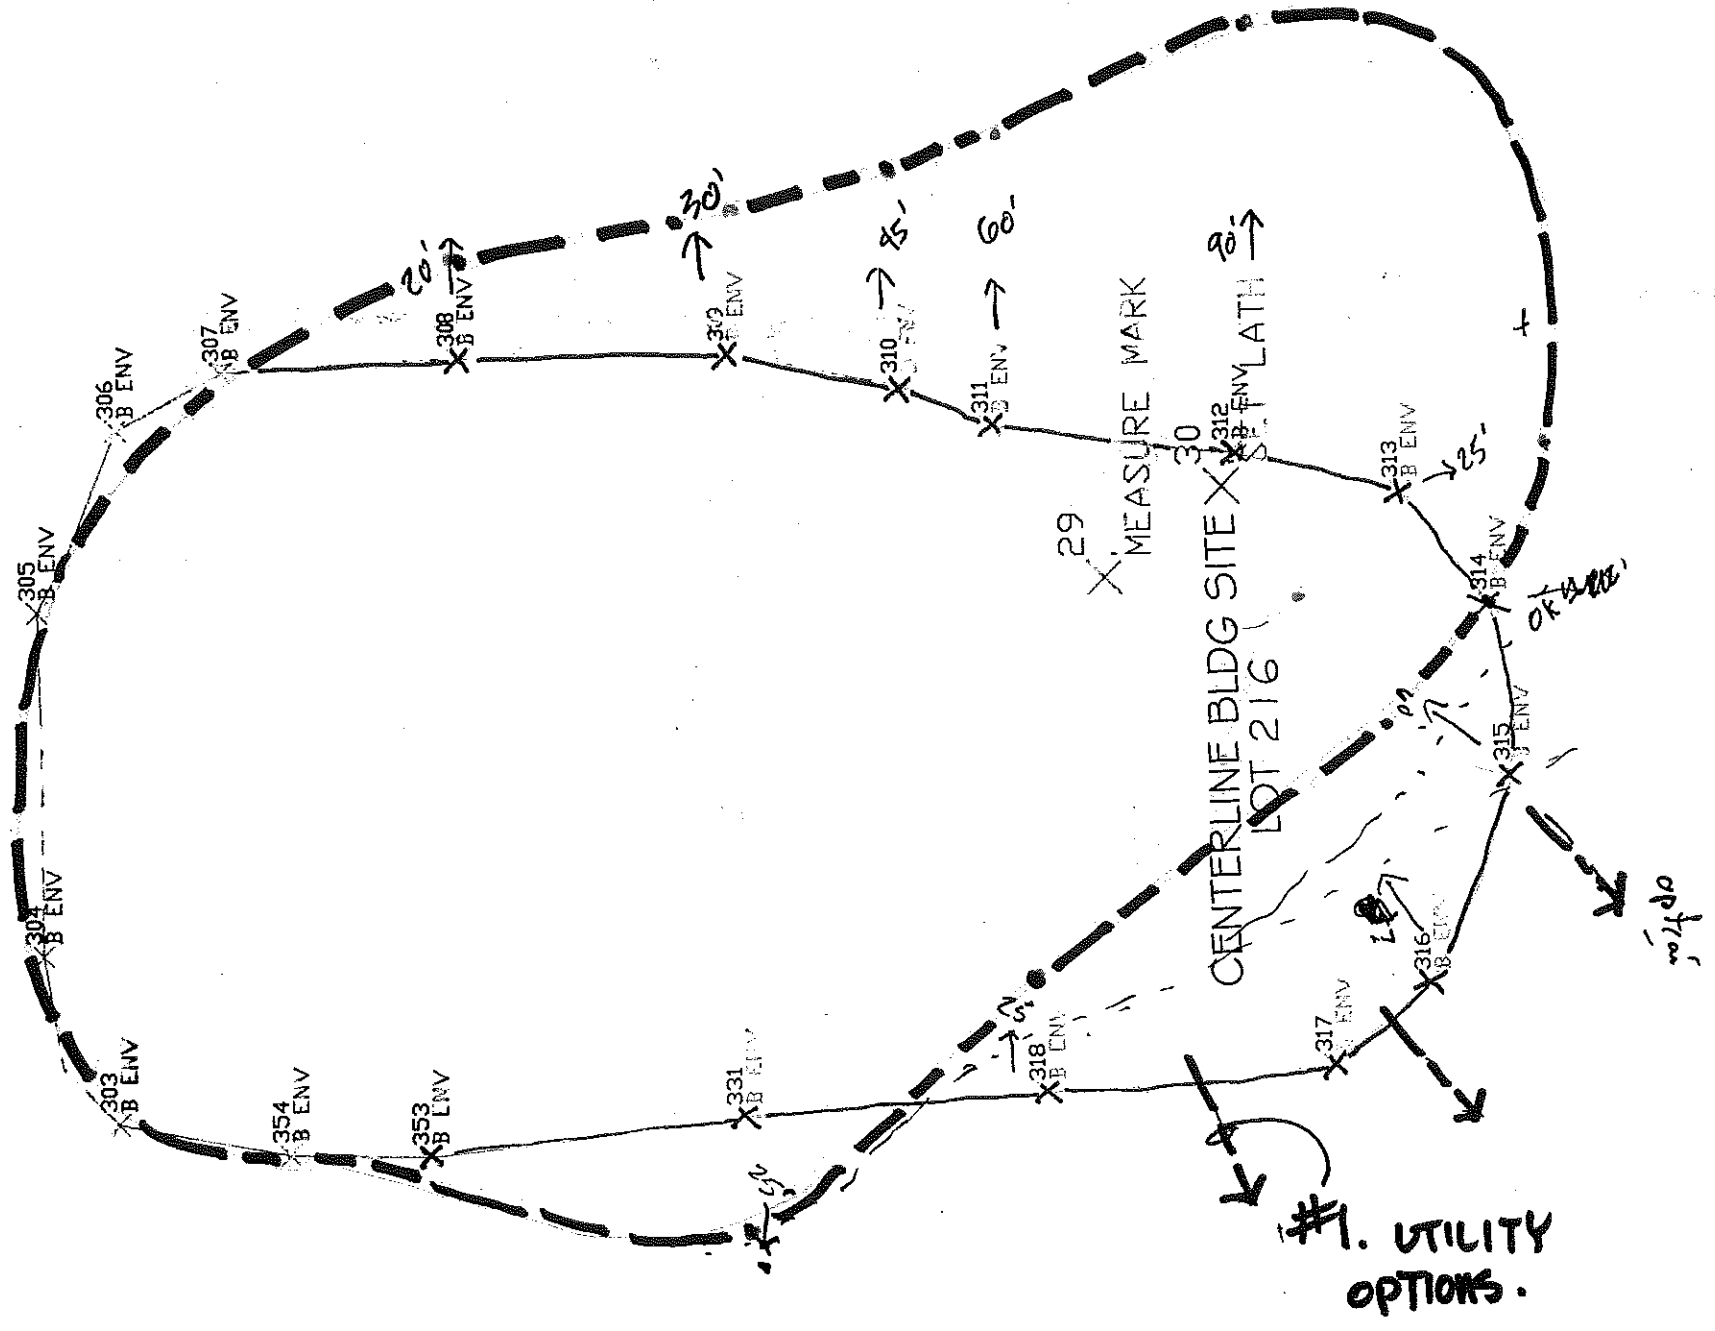

1:40 SCALE